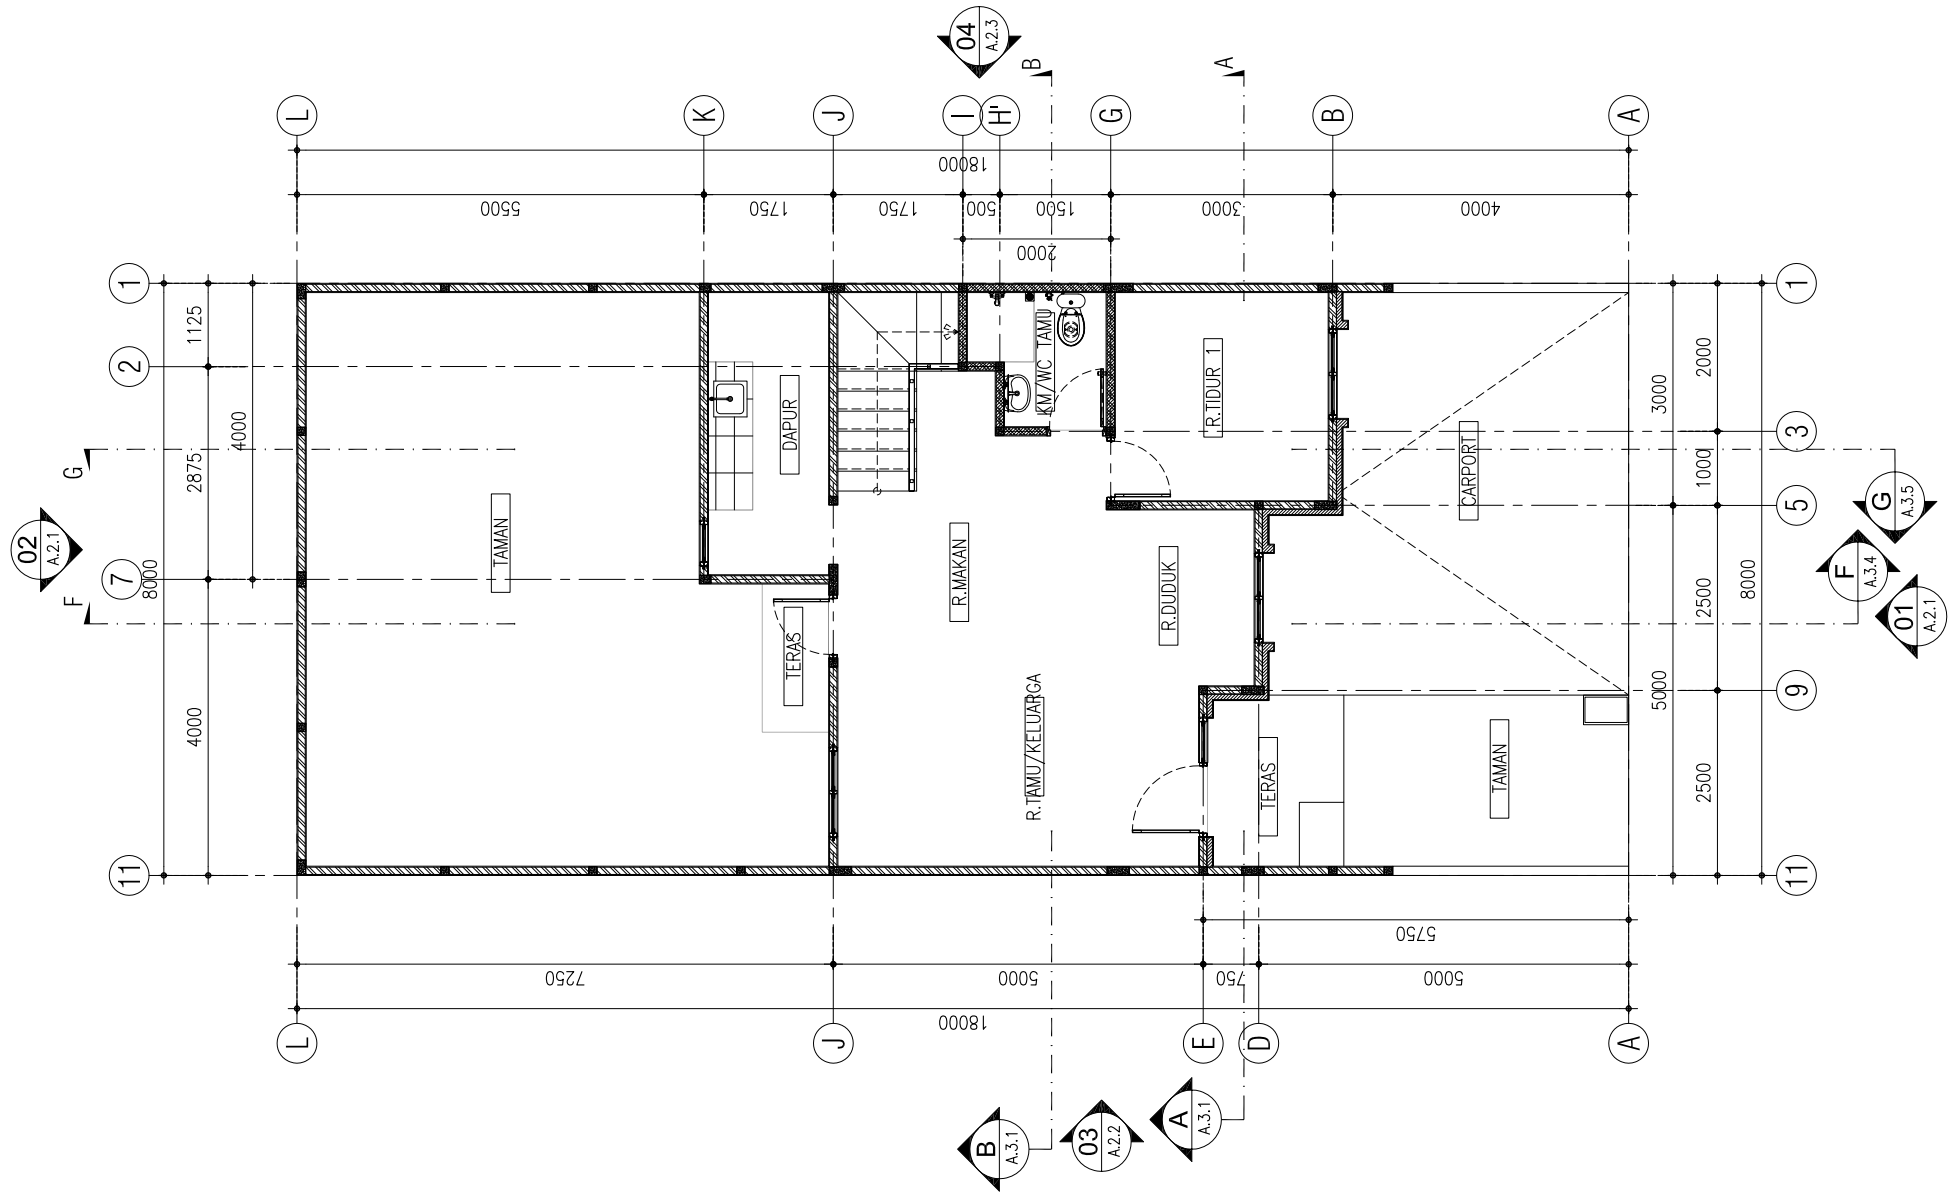


1 DENAH LT. DASAR
SKALA 1:100

| PROYEK / PROJECT | PENGEMBANG / DEVELOPER | KONTRAKTOR : | NAMA GAMBAR / DRAWING TITTLE | SKALA GAMBAR / DRAWING SCALE | | | | DRAWING NO. | NO. | REVISI | PARAF R1 | R2 | R3 |
|---|---|---|---|---|---|---|---|---|---|---|---|---|---|
| RUMAH TINGGAL<br>" NARA VILLAGE "<br>TYPE L8x18 STANDAR | PARAMOUNT LAND<br>Building homes and people with heart | | DENAH LT. DASAR | 1:100 | DIGAMBAR / DRAWN BY | TGL / DATE | | A.1.1 | | | | | |
| | | | | | DIPERIKSA / CHECKED BY | TGL / DATE | | | | | | | |
| | | | | | DISETUJUI / APPROVED BY | TGL / DATE | | | | | | | |
| | | | | DIKELUARKAN UNTUK / ISSUED FOR | NAMA FILE : ASBUILTDRAWING | | | No. PROYEK / PROJECT NUMBER | | | | | |
| | | | | | TANGGAL / DATE | | | | | | | | |